



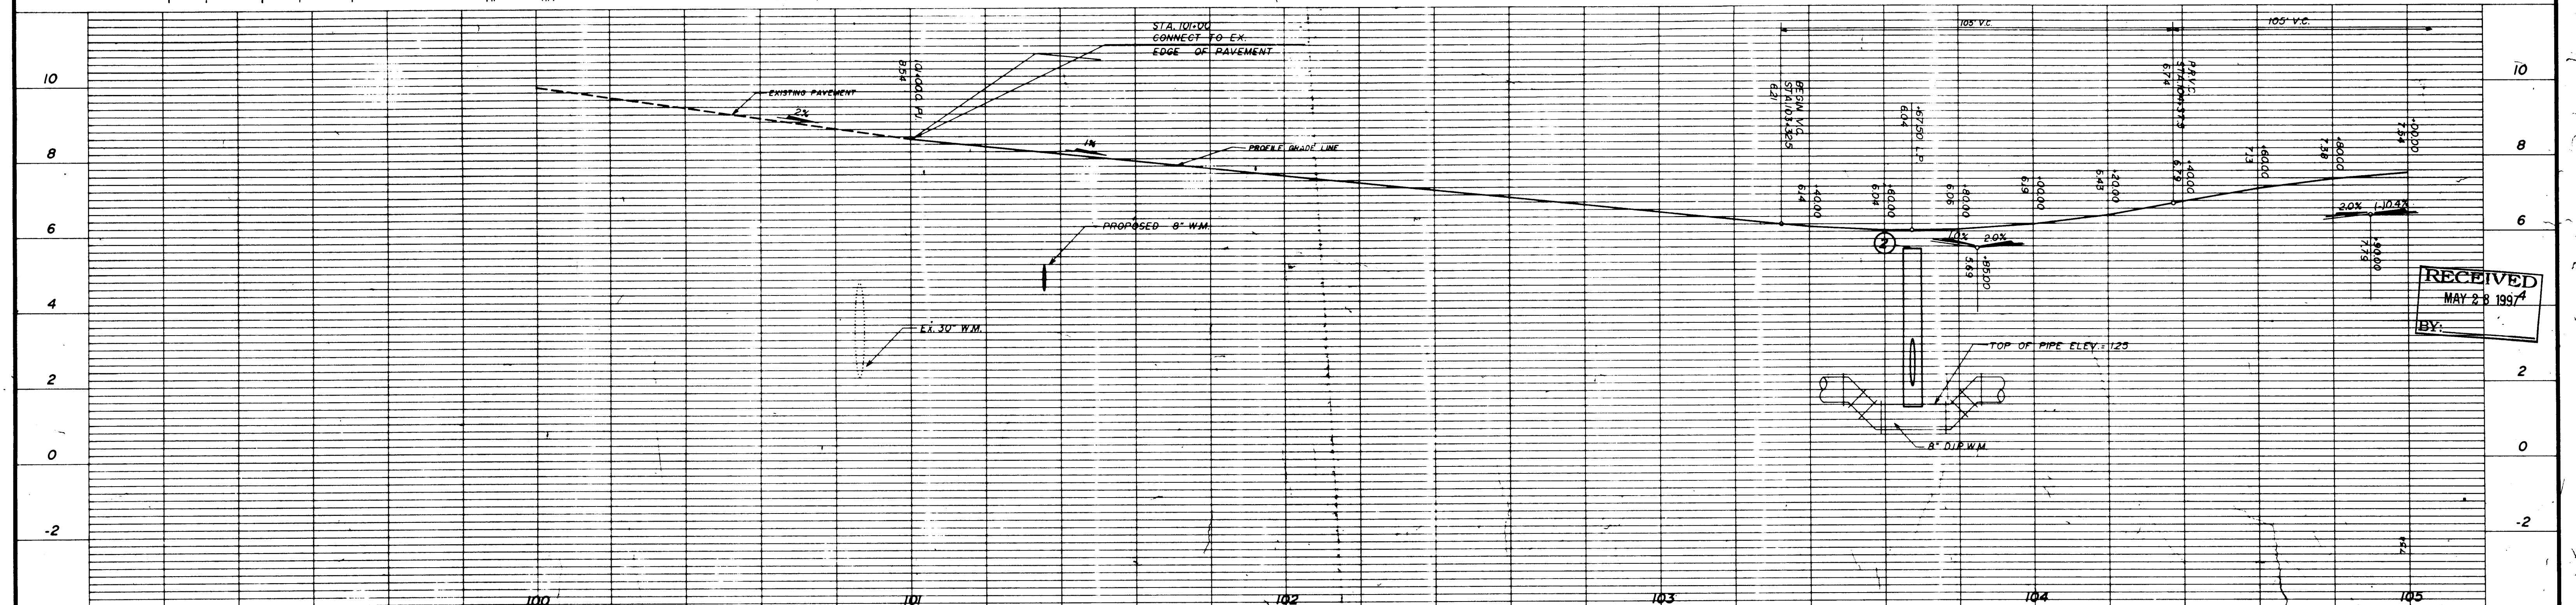
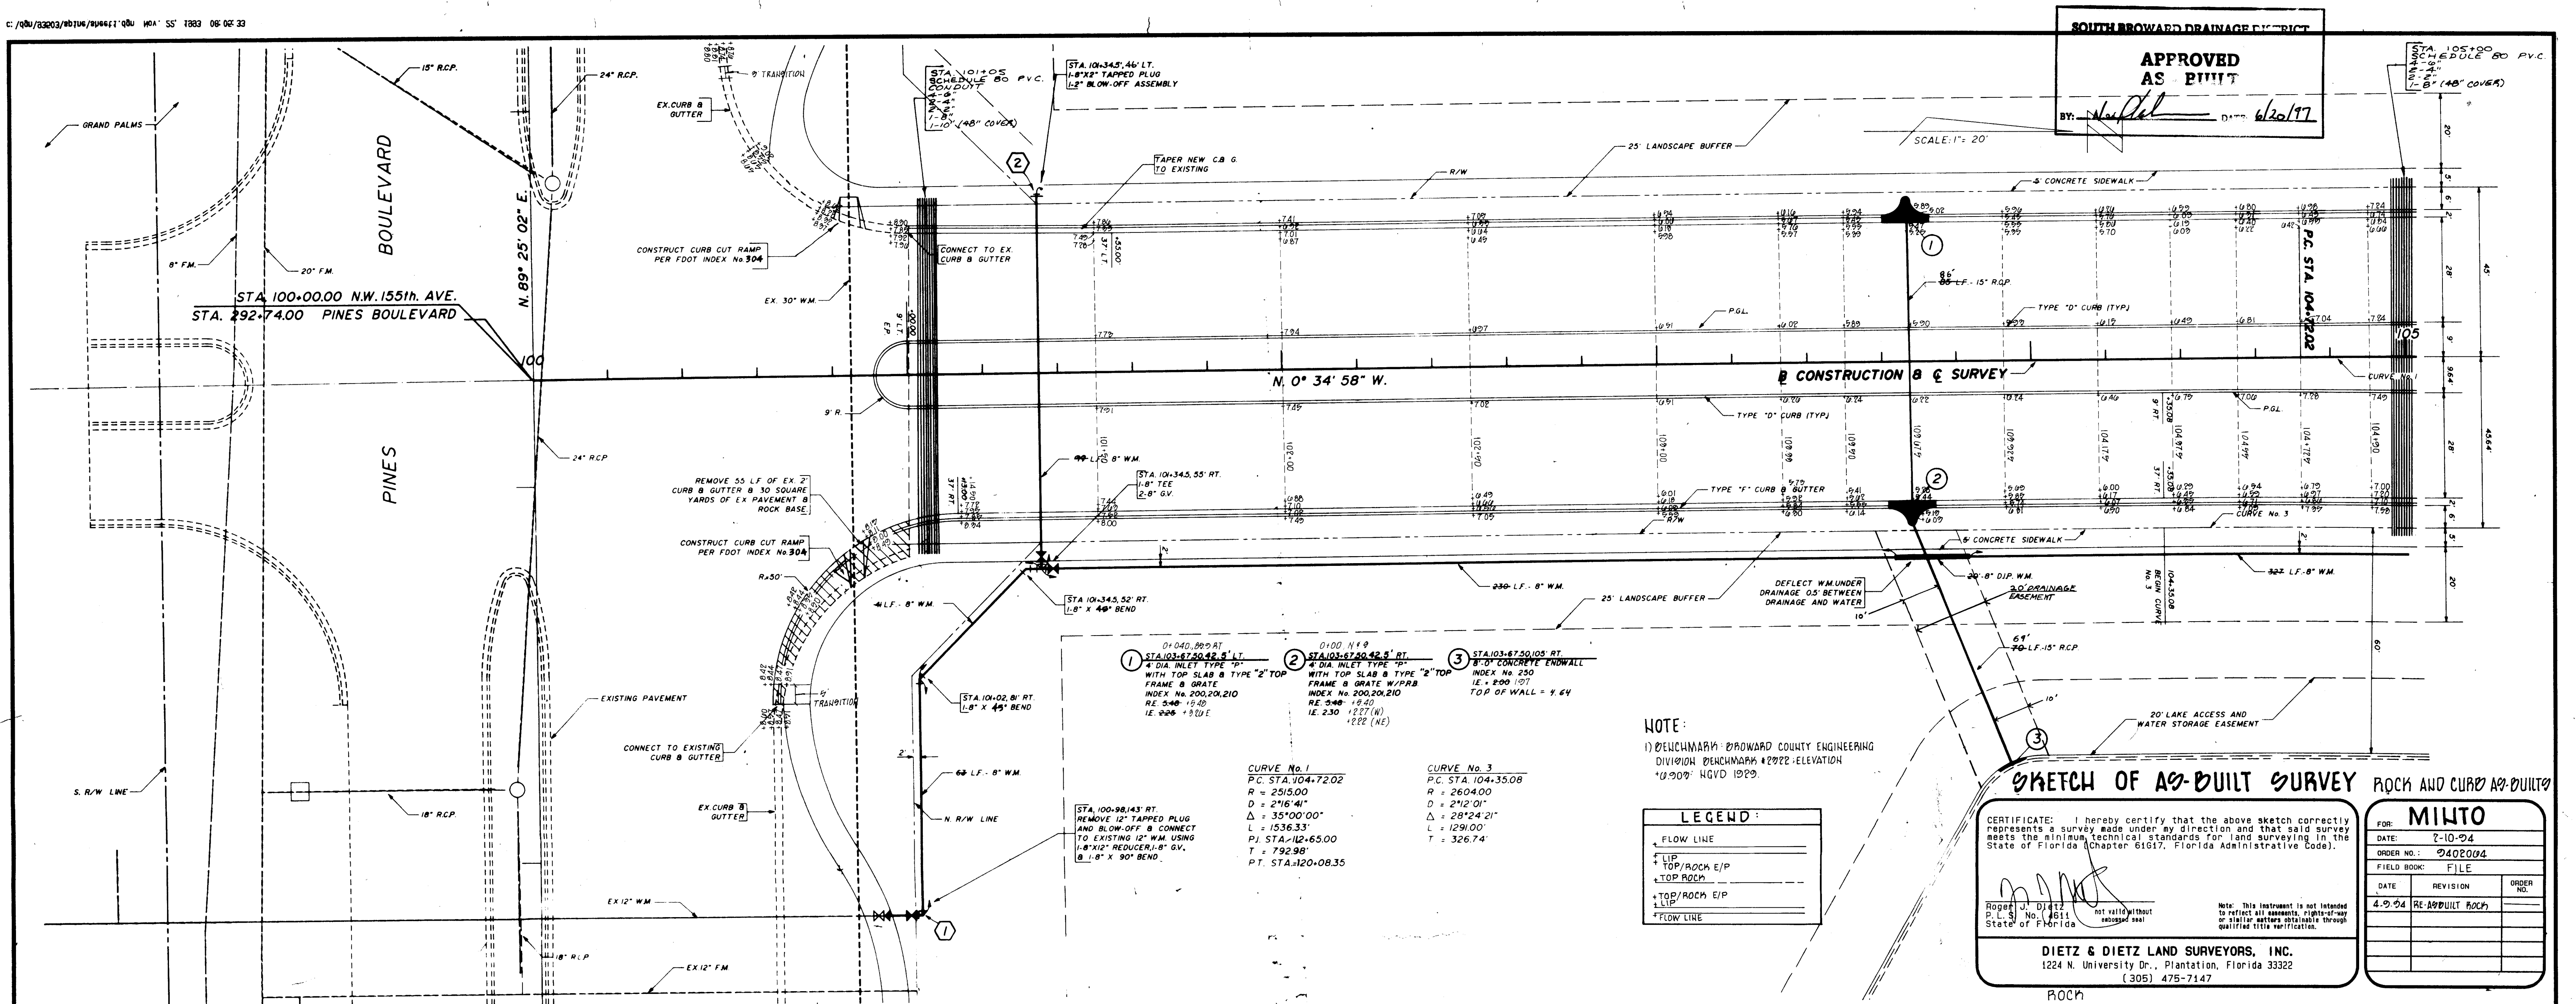
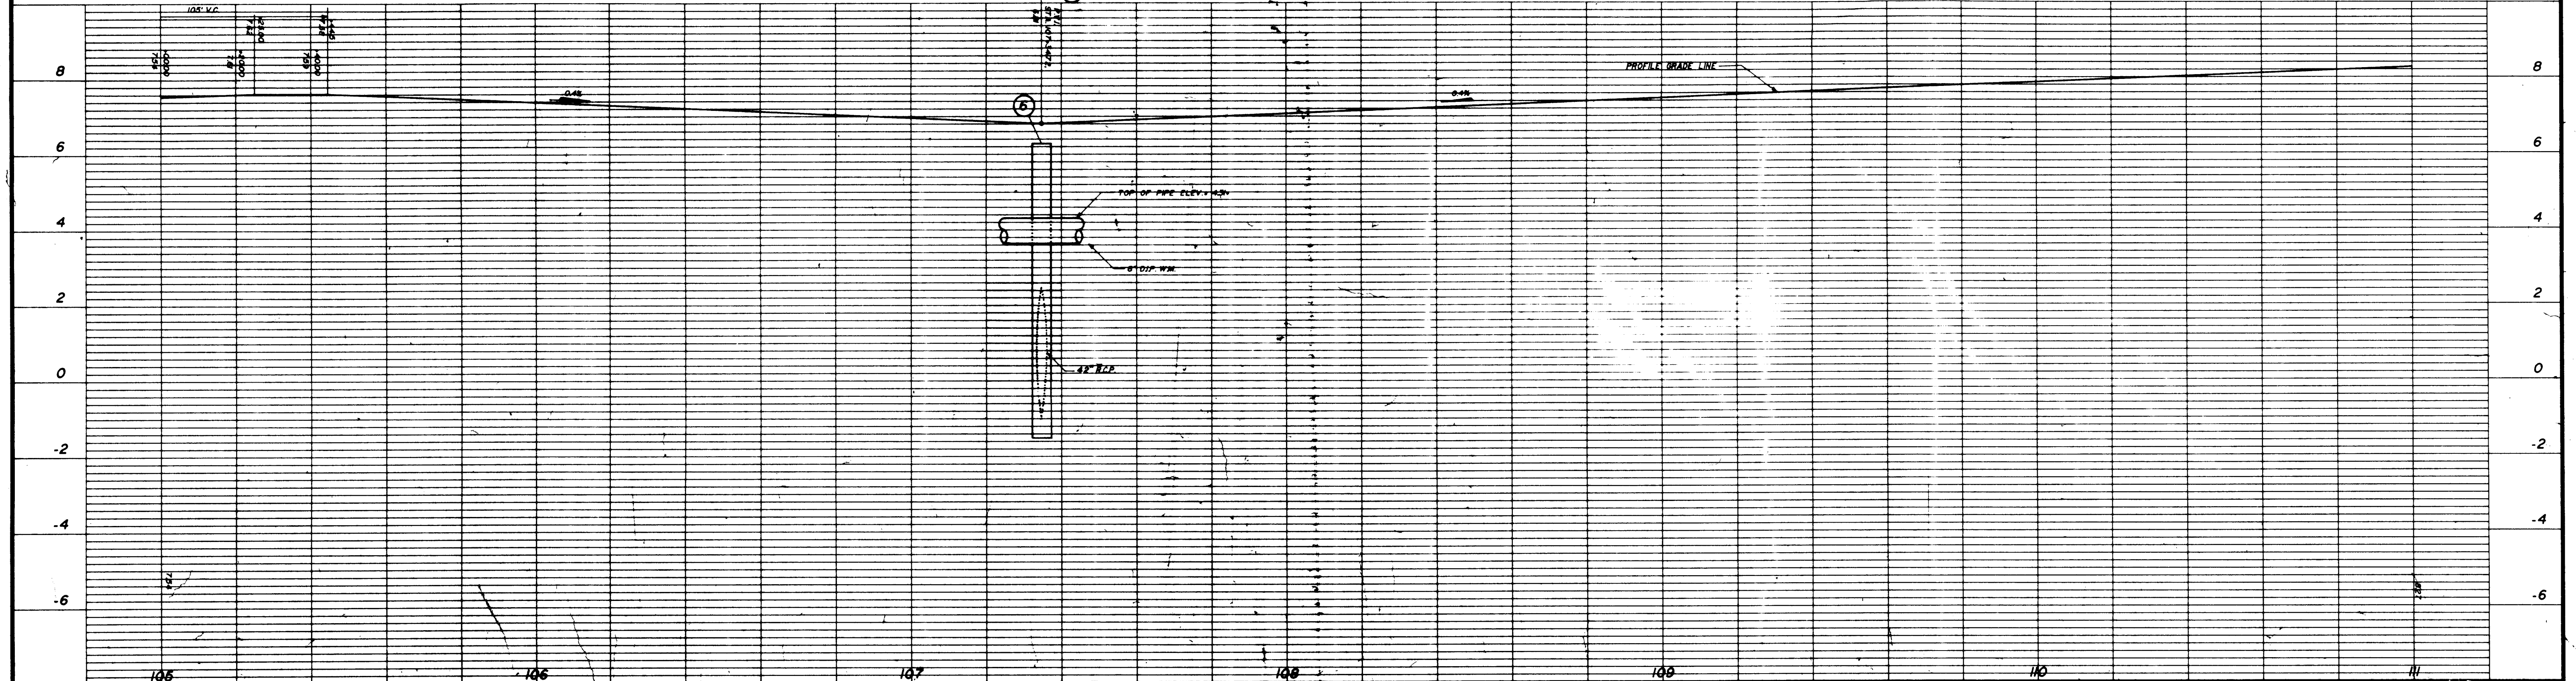


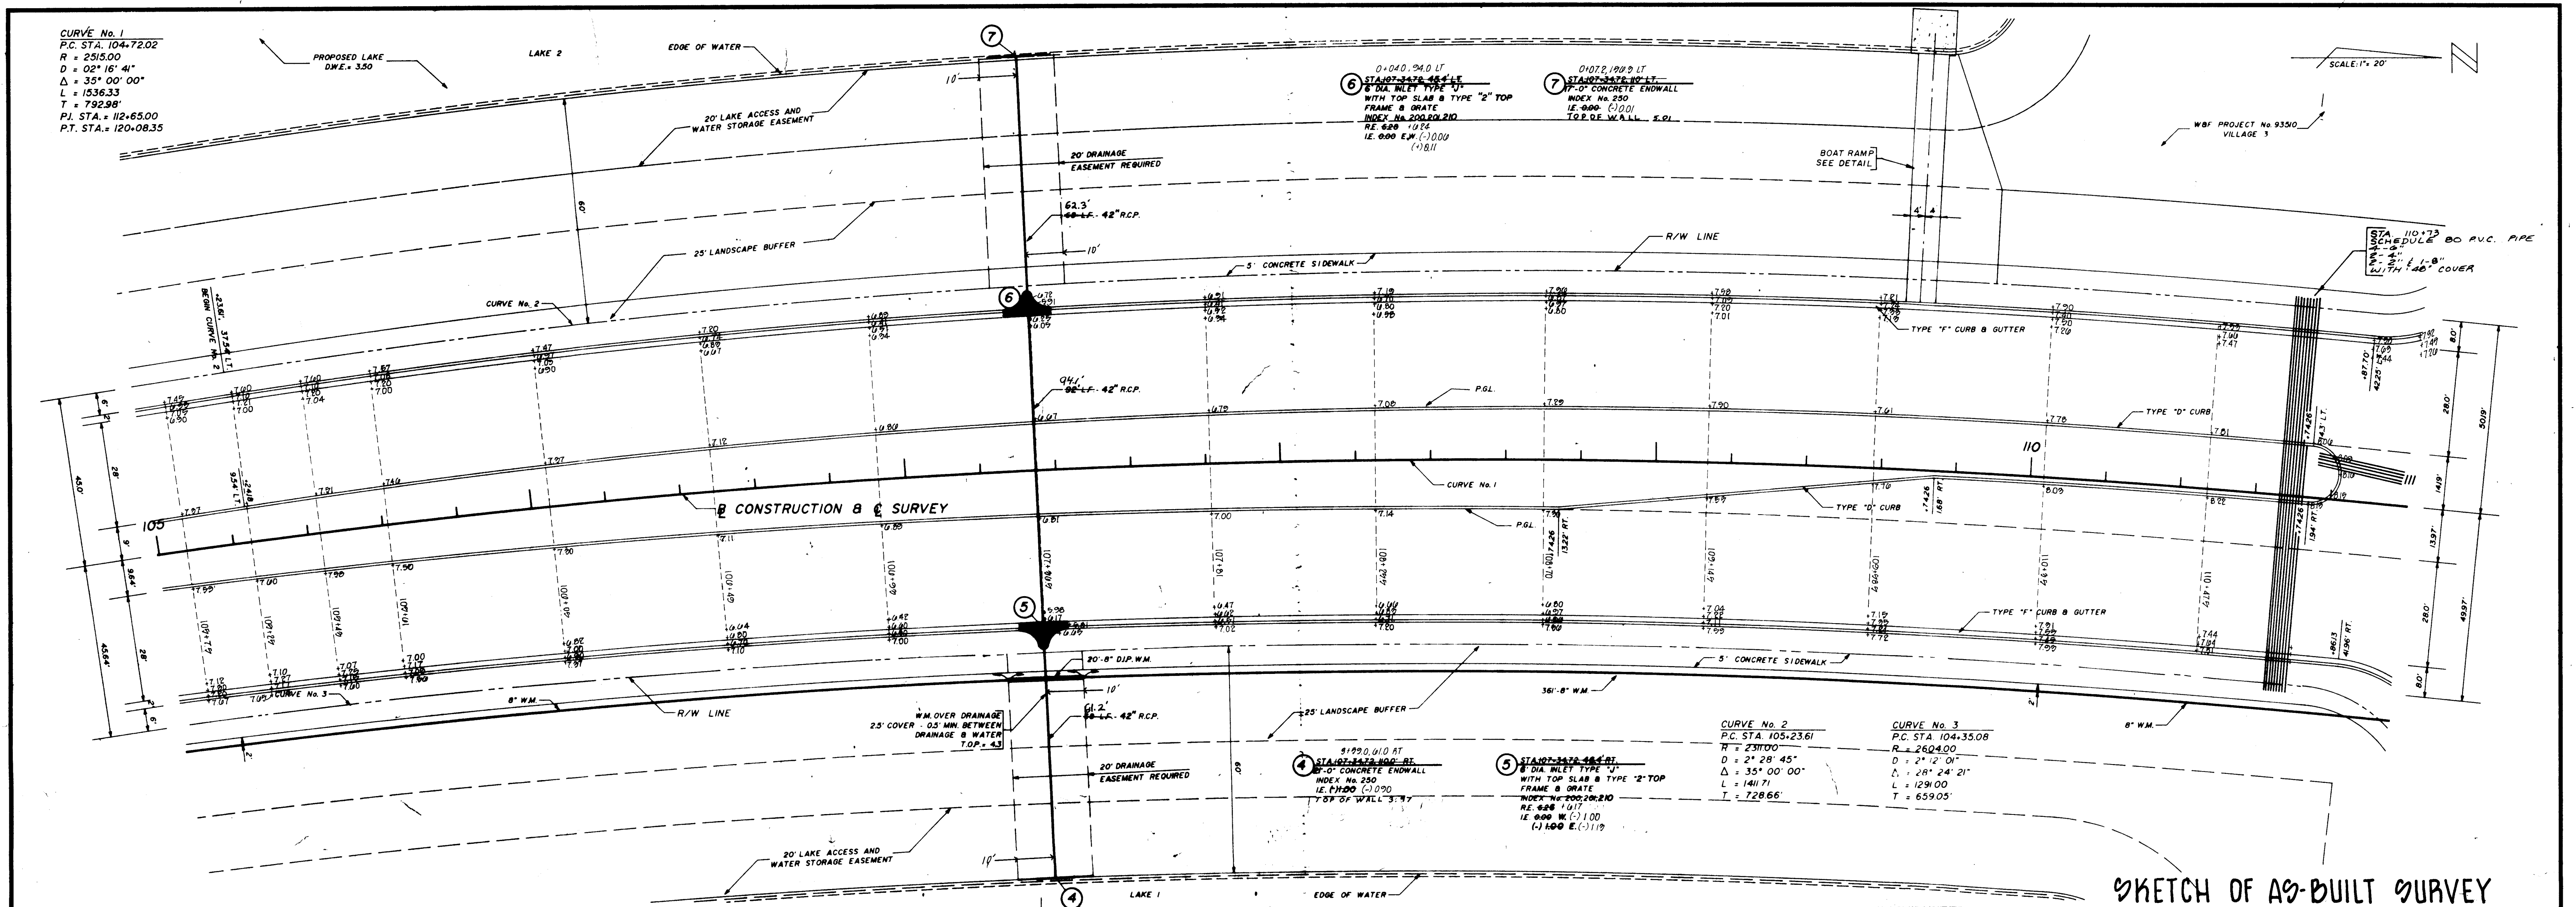


1/14/94	ADD CONDUIT CROSSING	DESIGNED: G.S.B. DATE: 6-93	TOWNGATE MINTO COMMUNITIES (PEMBROKE), INC. - GENERAL PARTNER	N.W. 155th AVENUE STA. 100+00 TO 105+00	WINNINGHAM & FRADLEY, INC. ENGINEERS • PLANNERS • SURVEYORS	APPROVED: <i>[Signature]</i>
6/16/93	REVISE PER PINES UTILITIES	DRAWN: D.D.D. DATE: 6-93				DATE: 6/20/17
6/16/93	REVISE PER PINES ENGINEERING	CHECKED: DATE:				PROJECT NUMBER: 93523
REVISIONS	DATE	REVISIONS				SHEET: 13 OF 19

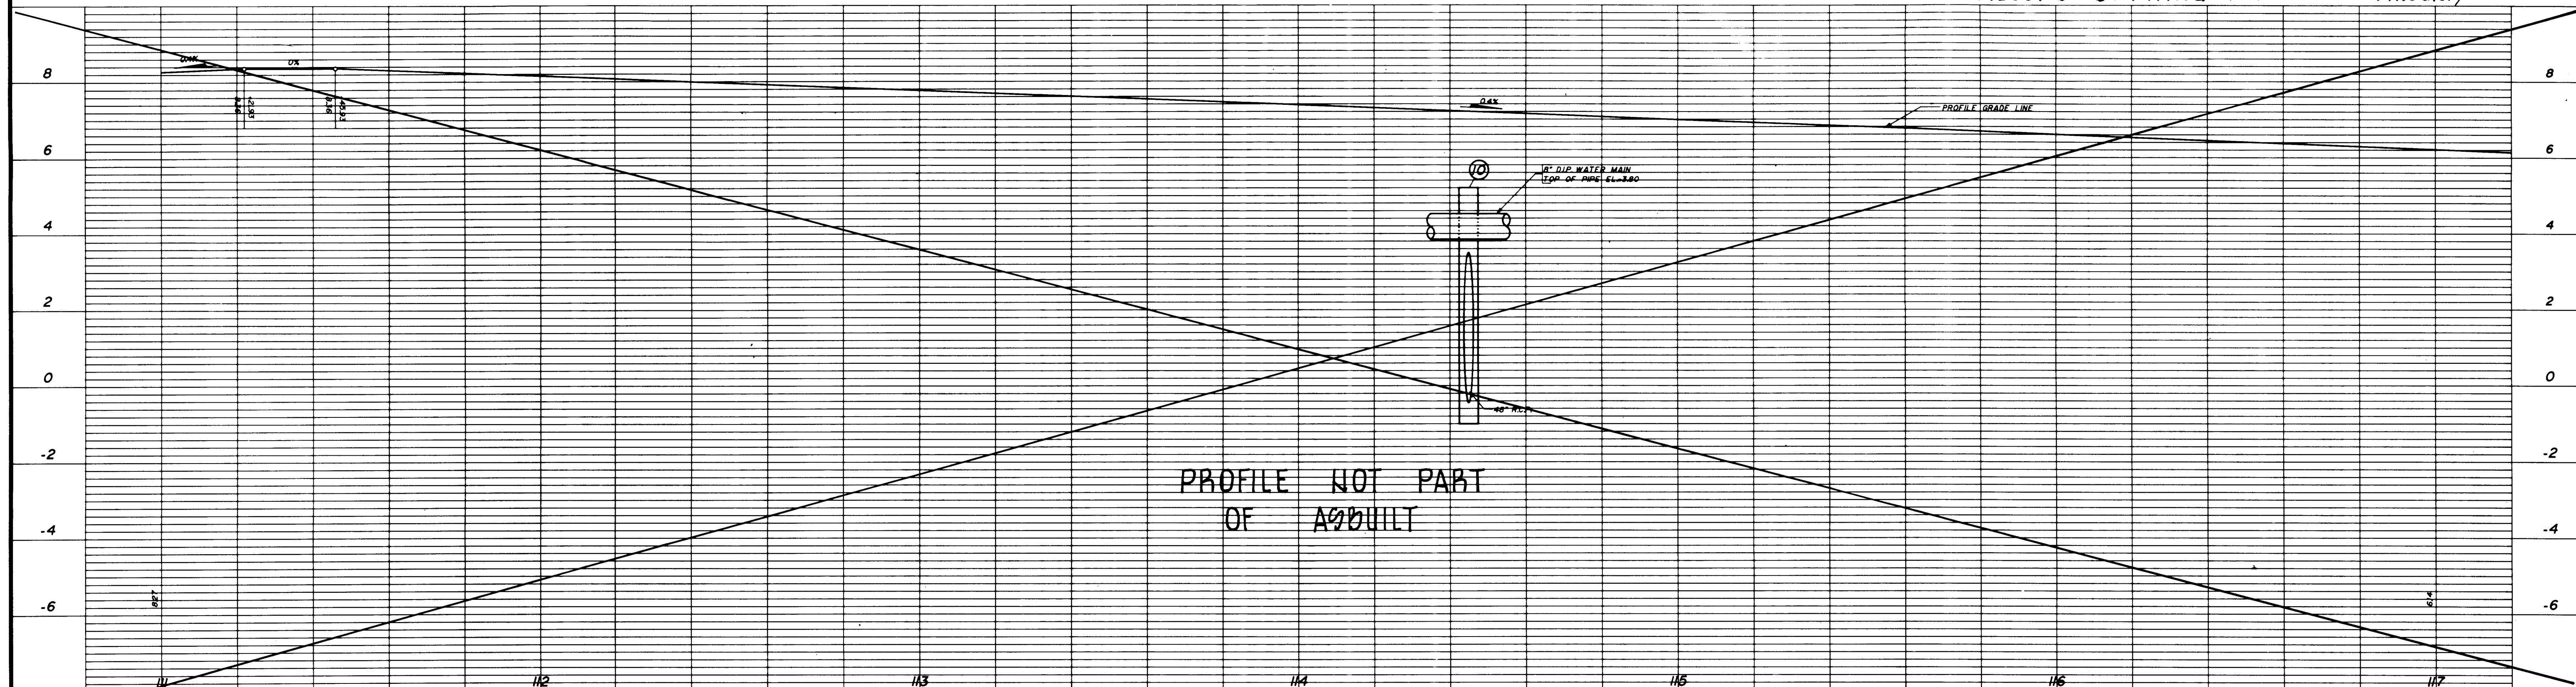

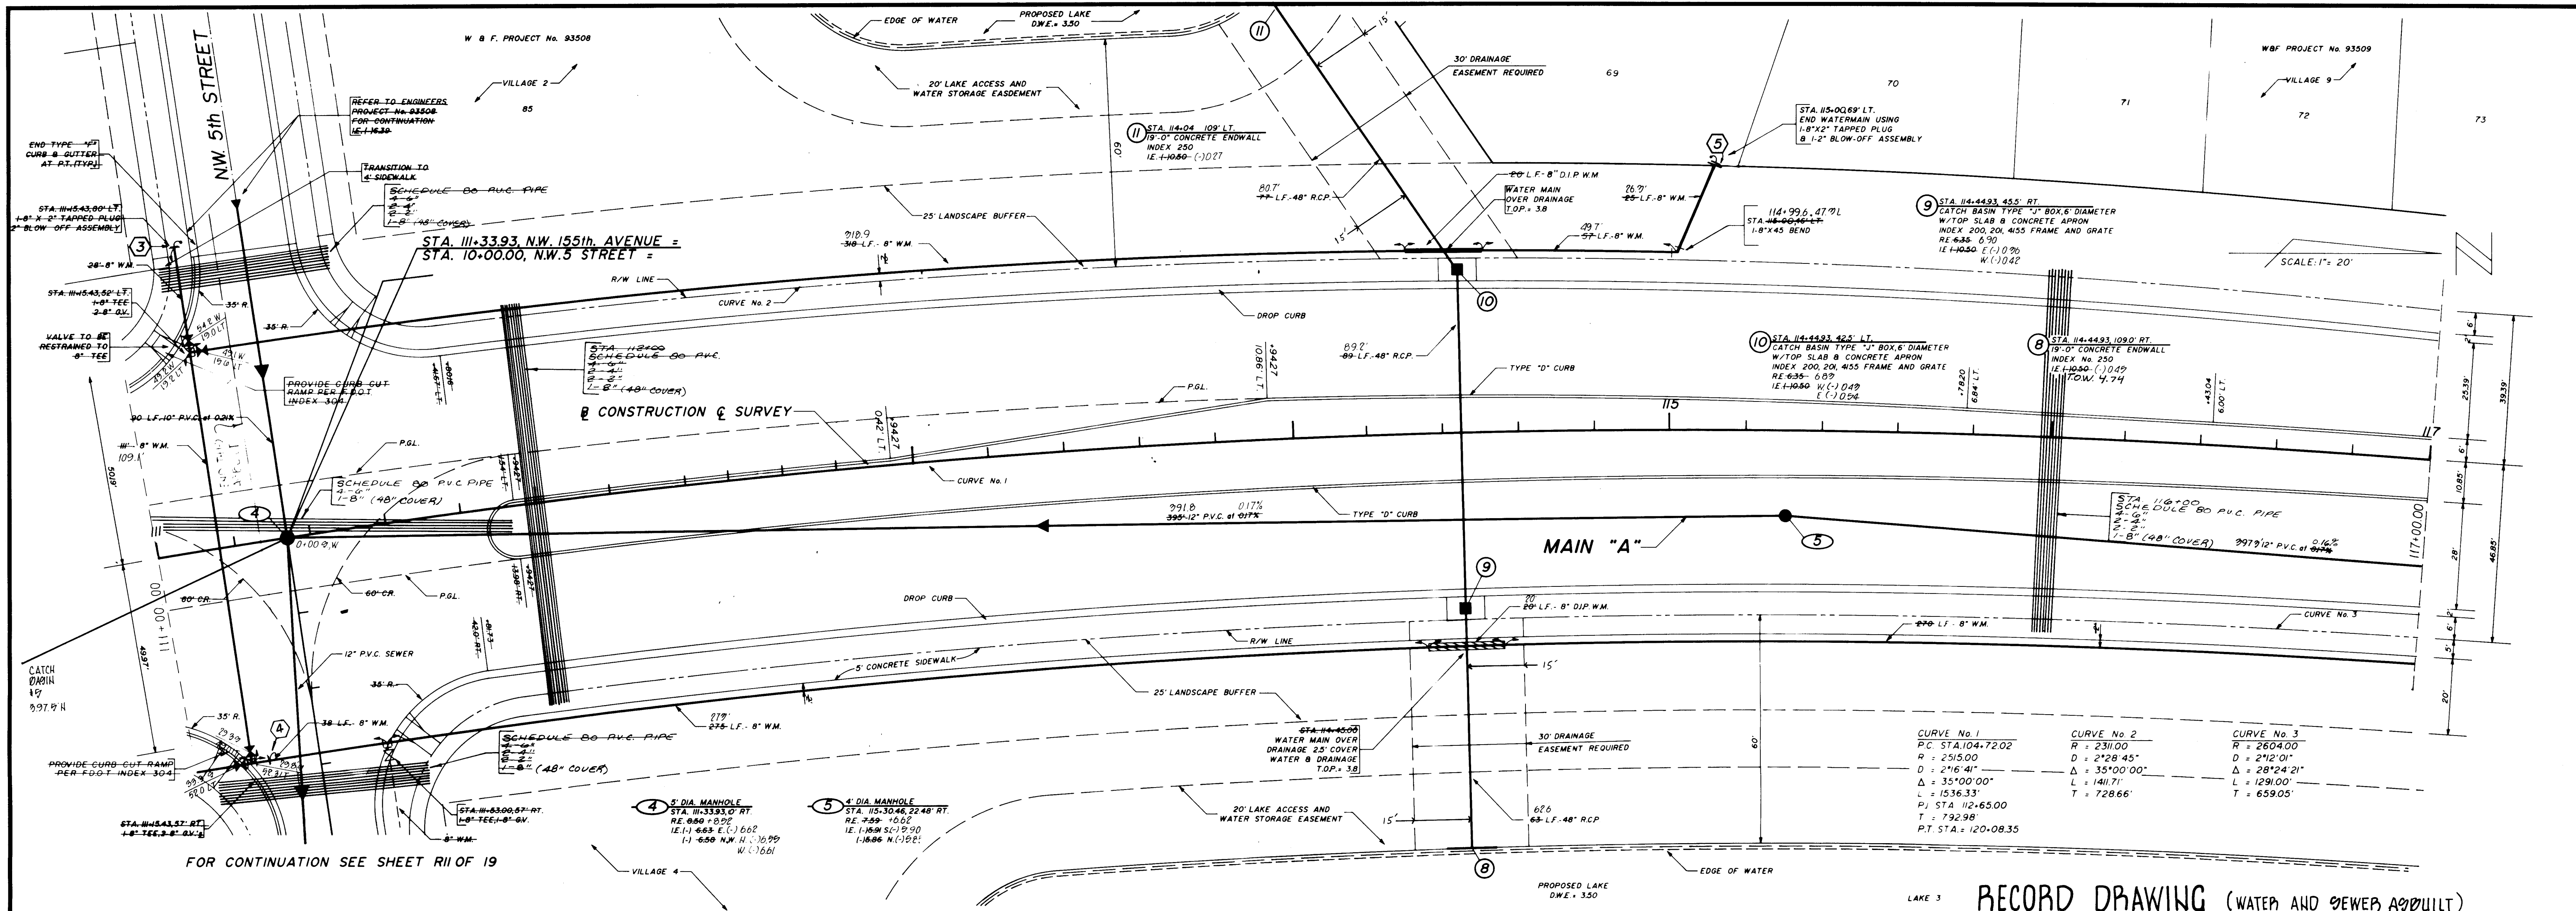

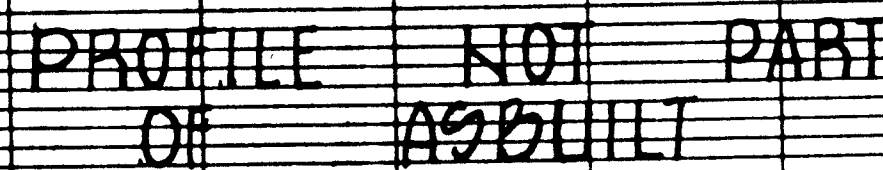

RECORD DRAWING

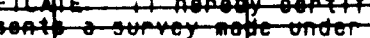CERTIFICATE: I hereby certify that the above sketch correctly represents a survey made under my direction and that this survey meets the minimum requirements of the laws of the State of Florida (CHAPTER 321, FLORIDA AGRICULTURAL CODE).		FOR: MINTO	
		DATE: 4-20-94	
COUNTY: FLORIDA		ORDER NO.: 0404092	
FIELD NO.: 163 2P		DATE: REVISION	
DITZ & DITZ LAND SURVEYORS, INC. 1224 N. UNIVERSITY BLVD., FORT WORTH, TEXAS 76102-5322		ORDER NO.	



TOWNGATE
MINTO COMMUNITIES (PEMBROKE), INC. - GENERAL PARTNER

N.W. 155th AVENUE
STA. 117+00 TO 123+00



**WINNINGHAM &
FRADLEY, INC.**
ENGINEERS • PLANNERS • SURVEYORS

APPROVED: *[Signature]*
DATE: *[Signature]*
PROJECT NUMBER 93503 SHEET 16 OF 19
MAY 27 1997

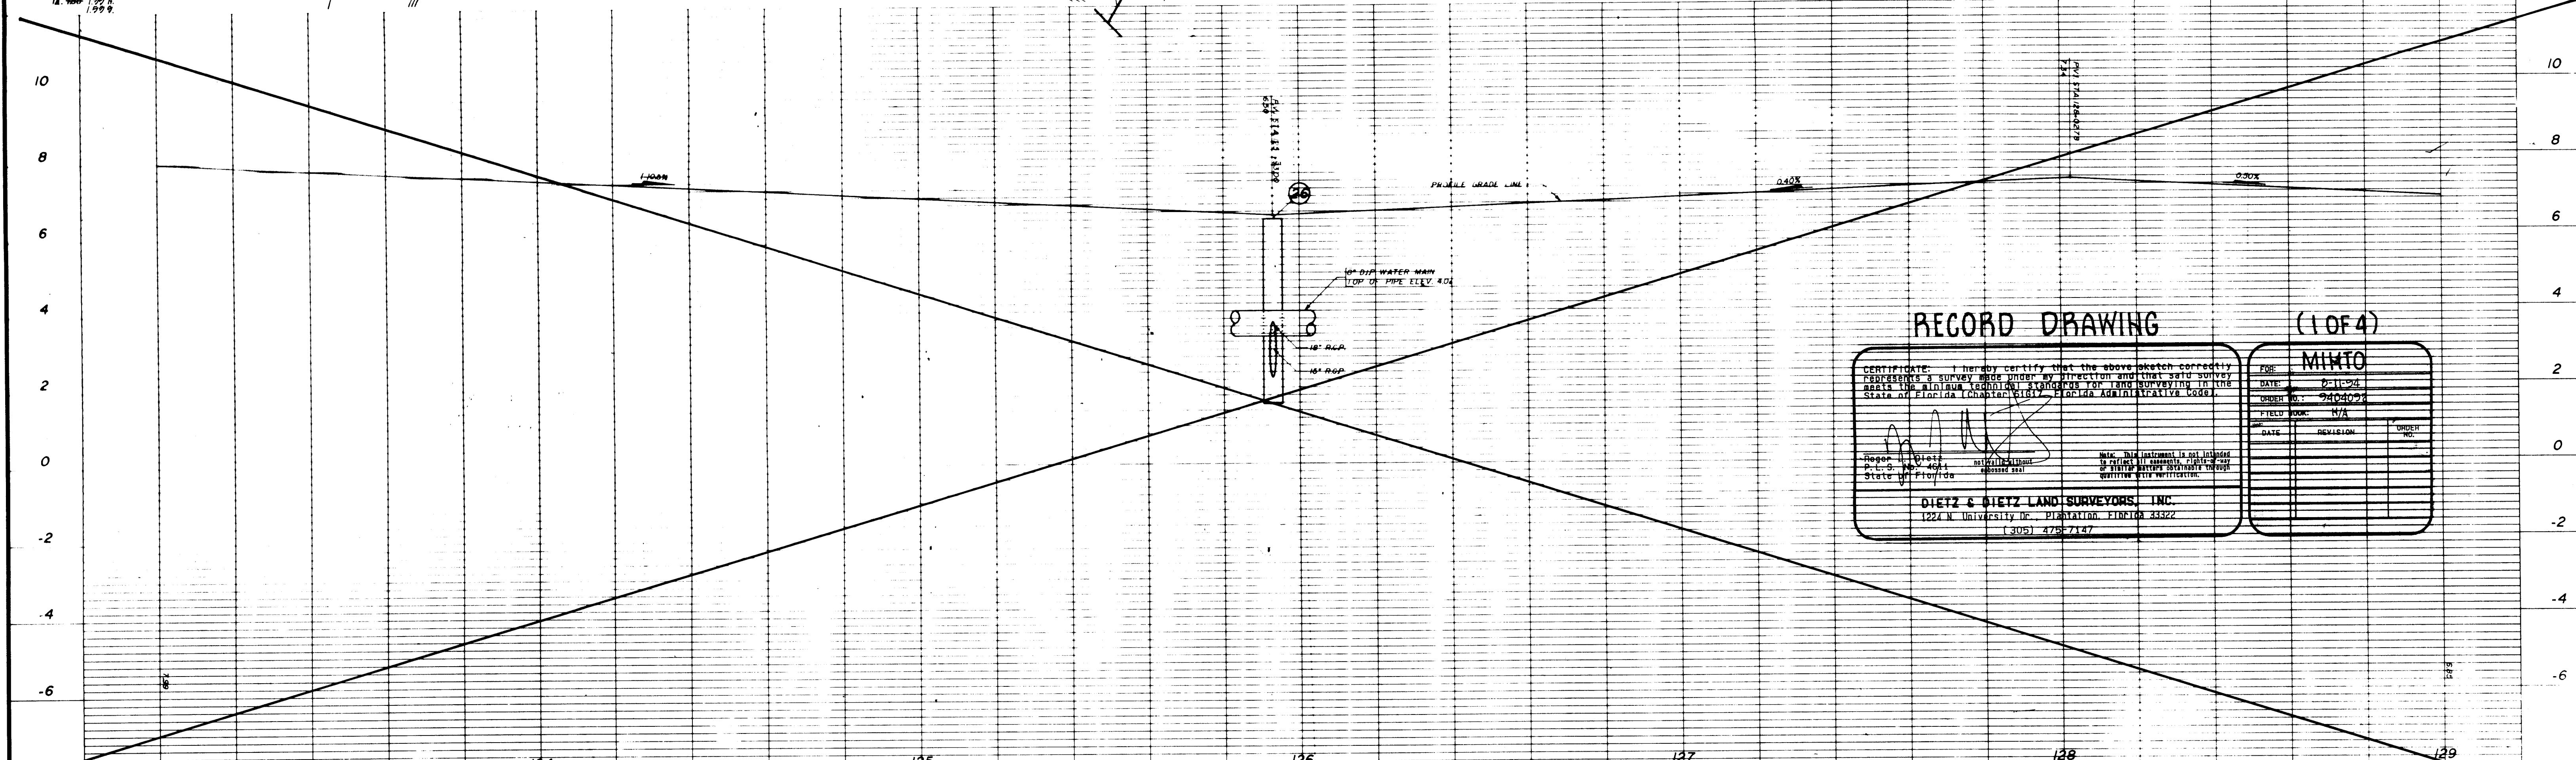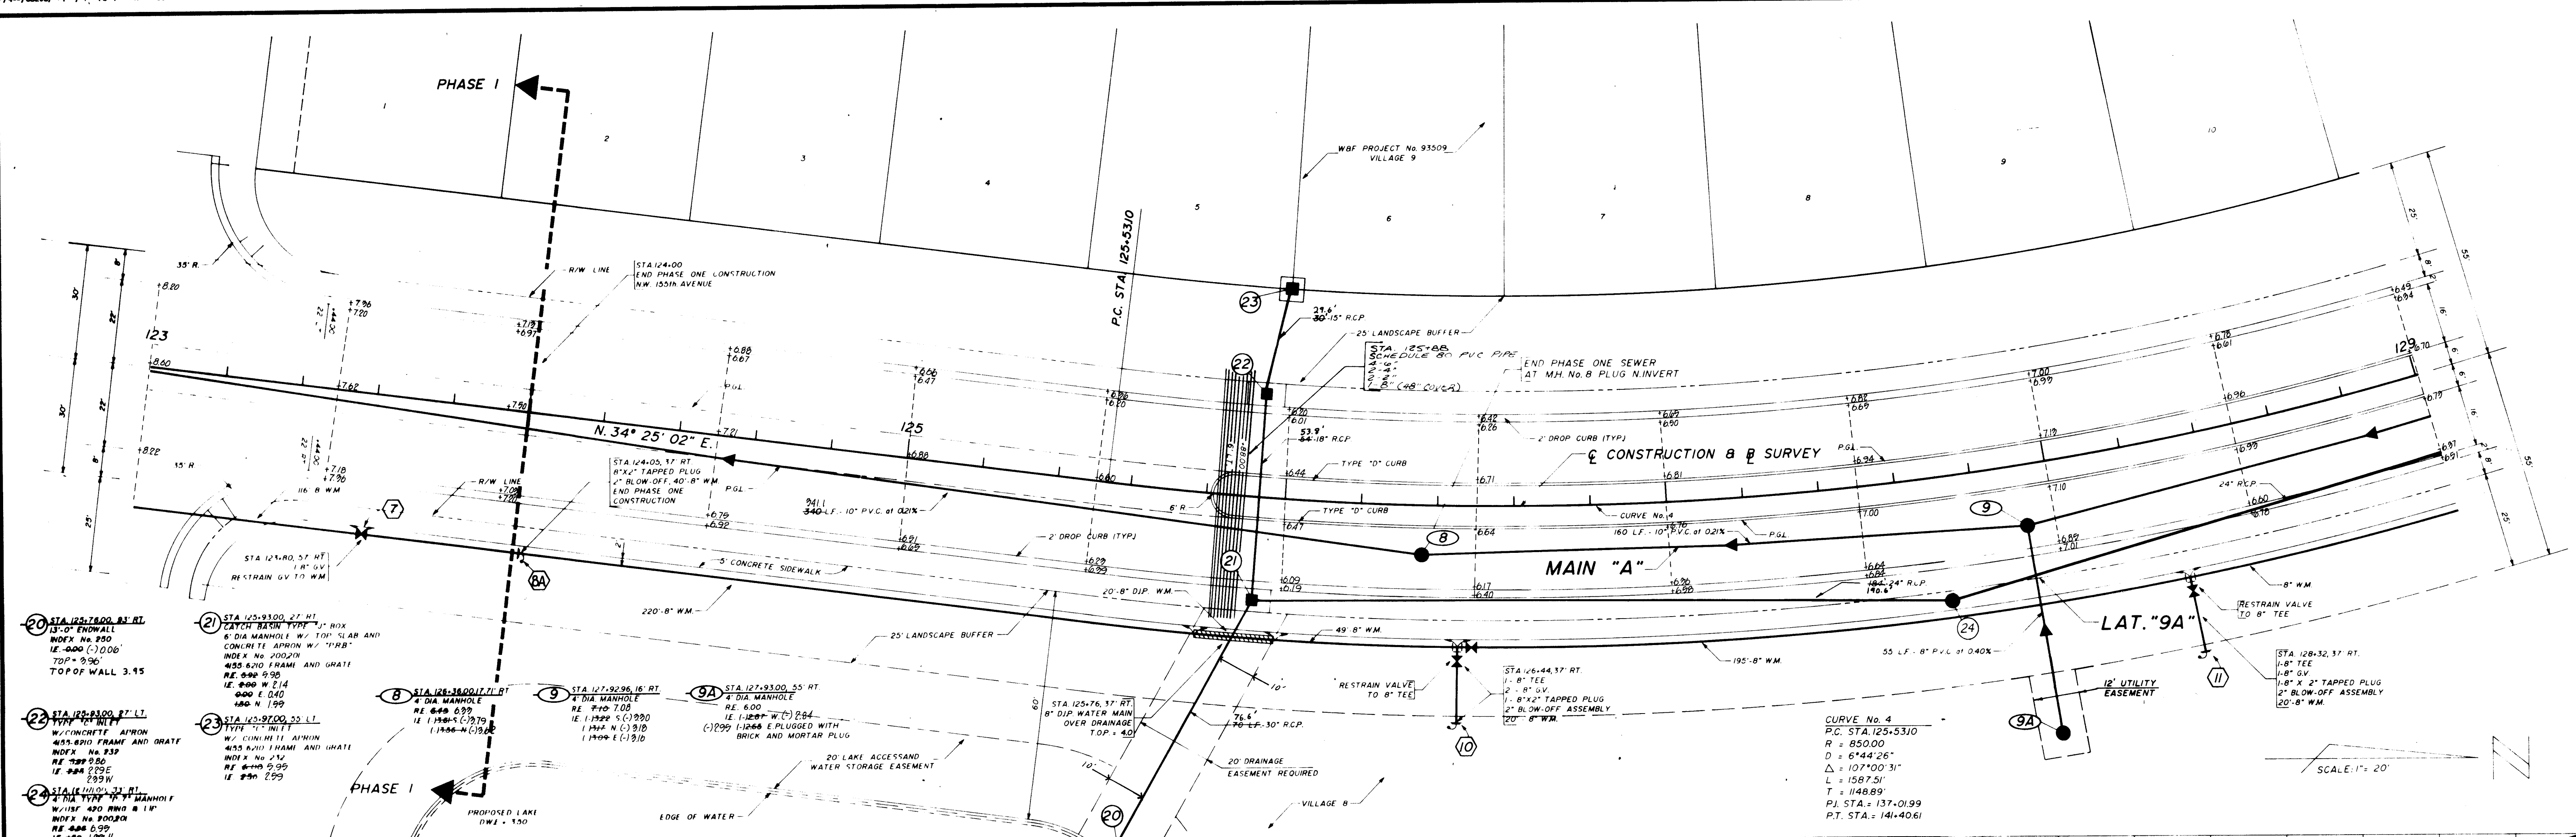

11/23/93	REVISE RUN 22-23	2/23/94	RELOCATE MH #24 TO STA 127+71.360	DESIGNED: G.S.B. DATE: 6-93
11/16/93	REVISE PER PEMBROKE PINES ENGINEERING	1/6/94	REVISE STRUCTURE #23 R/W ELEVATION	DRAWN: D.D.D. DATE: 6-93
11/16/93	REVISE PER PEMBROKE PINES UTILITIES	1/4/94	ADD CONDUIT CROSSING	CHECKED: G.S.B. DATE: 12/1/93
DATE	REVISIONS	DATE	REVISIONS	

TOWNGATE
MINTO COMMUNITIES (PEMBROKE), INC. - GENERAL PARTNER

1224 N. UNIVERSITY DR. PLANTATION, FLORIDA 33322
(305) 475-7127

N.W. 155th AVENUE
STA. 123.00 TO 129.00

WINNINGHAM & FRADLEY, INC.
ENGINEERS • PLANNERS • SURVEYORS

APPROVED: [Signature]
PROJECT NUMBER: 93507
SHEET: 27 OF 19
DATE: MAY 21 1997

RECORD DRAWING (1 OF 4)

CERTIFICATE: I hereby certify that the above sketch correctly represents a survey made under my direction and that said survey was made in accordance with the laws and regulations of the State of Florida (Chapter 681, Florida Administrative Code).

Roger J. Dietz
Surveyor
State License No. 10108

FOR: MINTO

DATE: 6-11-94

ORDER NO.: 9404009

FIELD BOOK: N/A


DATE: 6-11-94

REVISION: 1

ORDER NO.:

NOTE: This instrument is not intended to be used in any other way than that for which it was designed. It is not to be used for any other purpose without the written consent of the Surveyor.

DIETZ & DIETZ LAND SURVEYORS, INC.
1224 N. UNIVERSITY DR. PLANTATION, FLORIDA 33322
(305) 475-7127

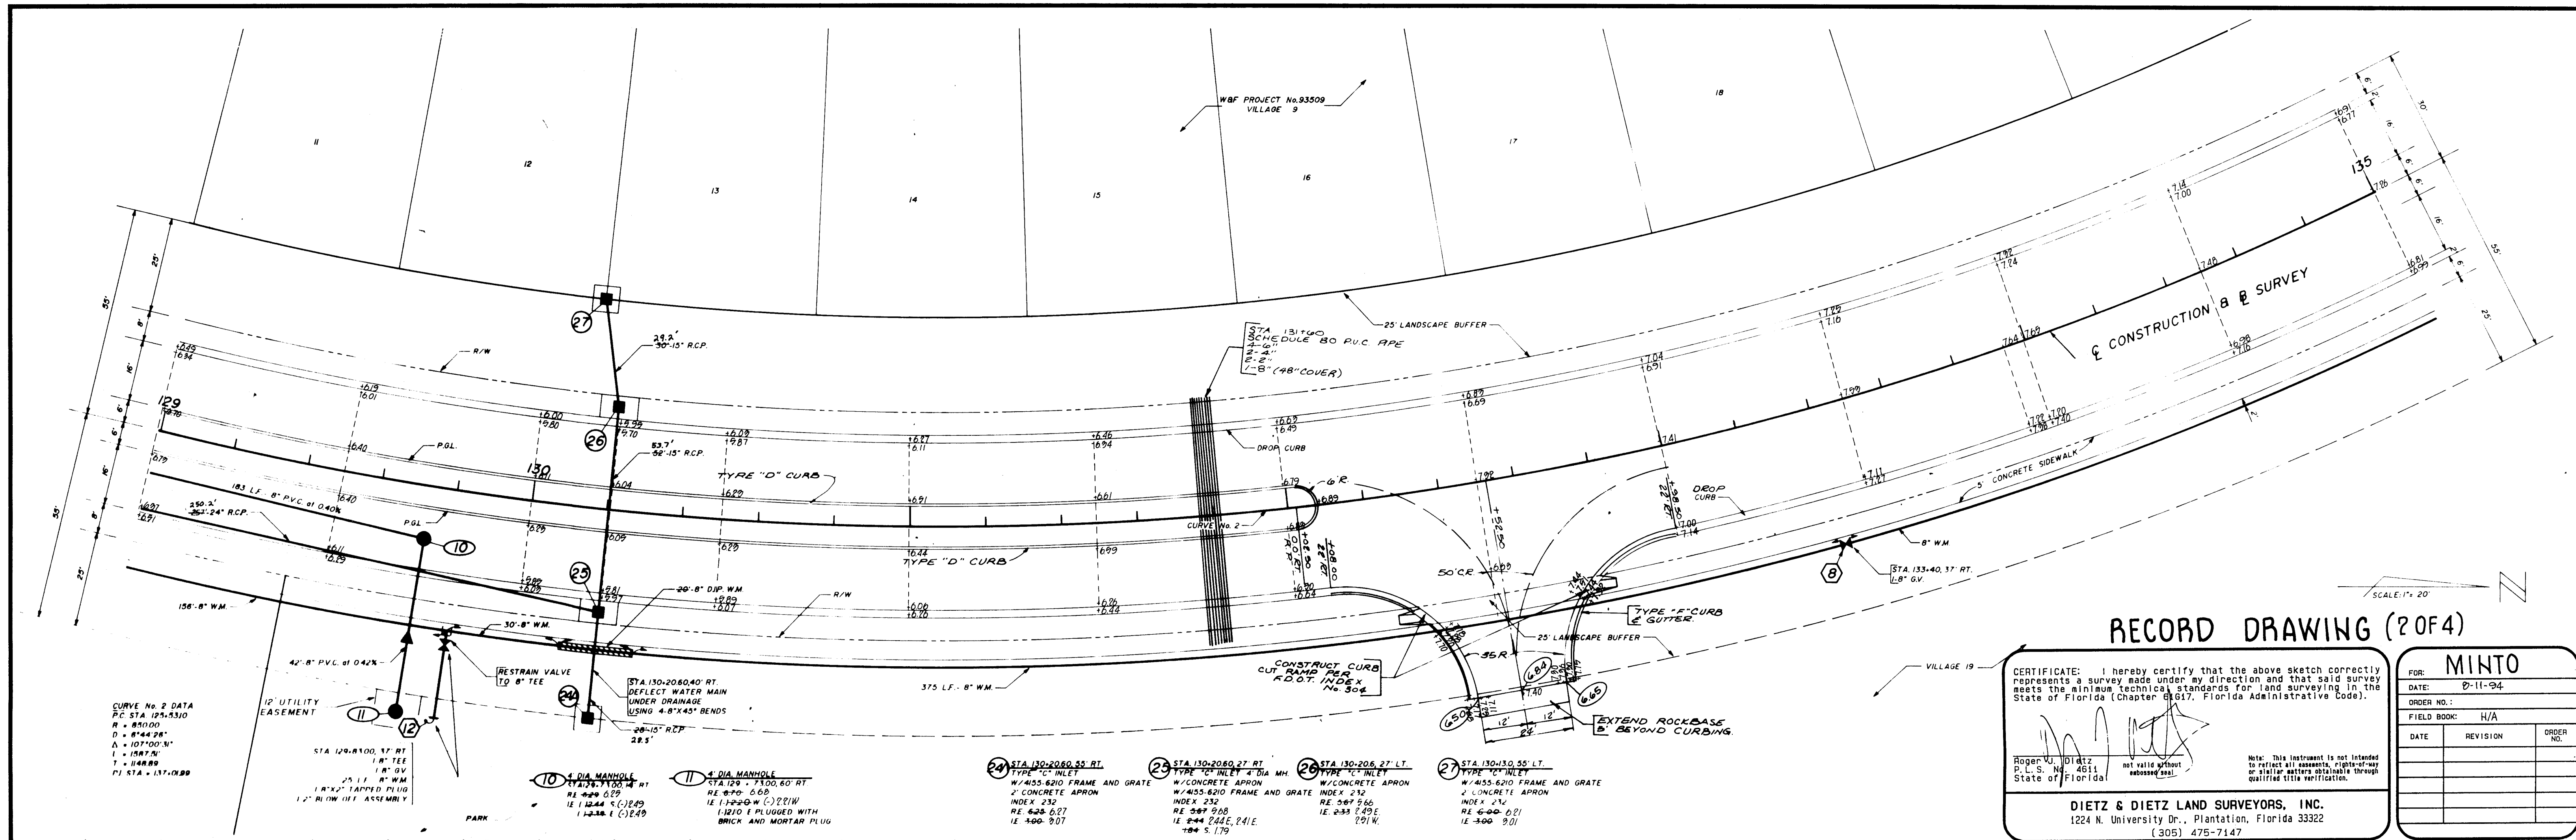


RECORD DRAWING (2 OF 4)

CERTIFICATE: I hereby certify that the above sketch correctly represents a survey made under my direction and that said survey meets the minimum technical standards for land surveying in the State of Florida (Chapter 617, Florida Administrative Code).

ROGER J. DIETZ
P.L.S. No. 4611
State of Florida

DIETZ & DIETZ LAND SURVEYORS, INC.
1224 N. University Dr., Plantation, Florida 33322
(305) 475-7147


FOR: MINTO		
DATE:	07-11-94	
ORDER NO.:		
FIELD BOOK:	H/A	
DATE	REVISION	ORDER NO.

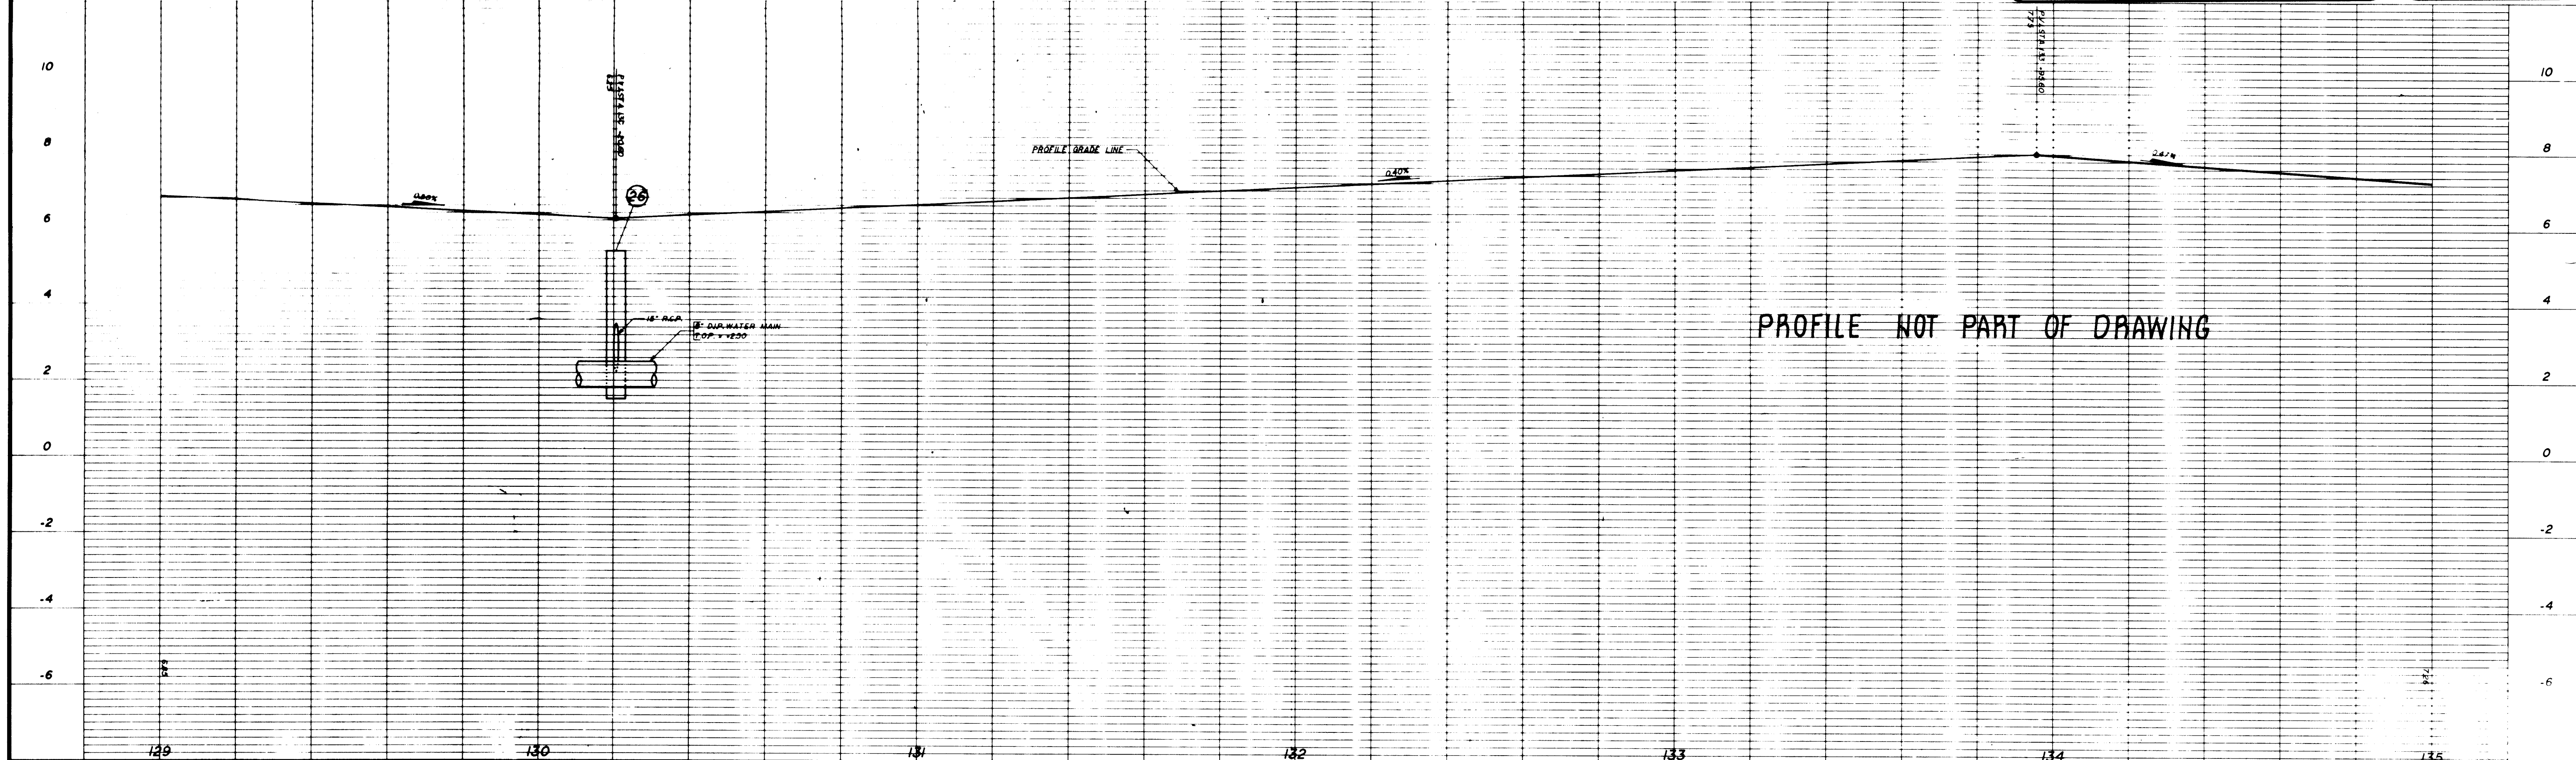

PROFILE NOT PART OF DRAWING

11/30/93	ADD UTILITY EASEMENT	7/5/94	ADD TURN LANE STA. 132+58.90	DESIGNED: G.S.B. DATE: 6-93	TOWNGATE MINTO COMMUNITIES (PEMBROKE), INC. - GENERAL PARTNER	N.W. 155th AVENUE STA. 129+00 TO 135+00	WINNINGHAM & FRADLEY, INC. ENGINEERS • PLANNERS • SURVEYORS	APPROVED: <i>[Signature]</i> DATE: 11/16/94 PROJECT NUMBER: 93503 SHEET: 18 OF 19
11/18/93	REVISE PER PEMBROKE PINES ENGINEERING	1/16/94	REVISE STRUCTURE #27 RISE ELEVATION	DRAWN: D.D.D. DATE: 6-93				
11/18/93	REVISE PER PEMBROKE PINES UTILITIES	1/14/94	ADD CONDUIT CROSSING	CHECKED: COW DATE: 12/1/93				
DATE	REVISIONS	DATE	REVISIONS					

MAY 27 1997

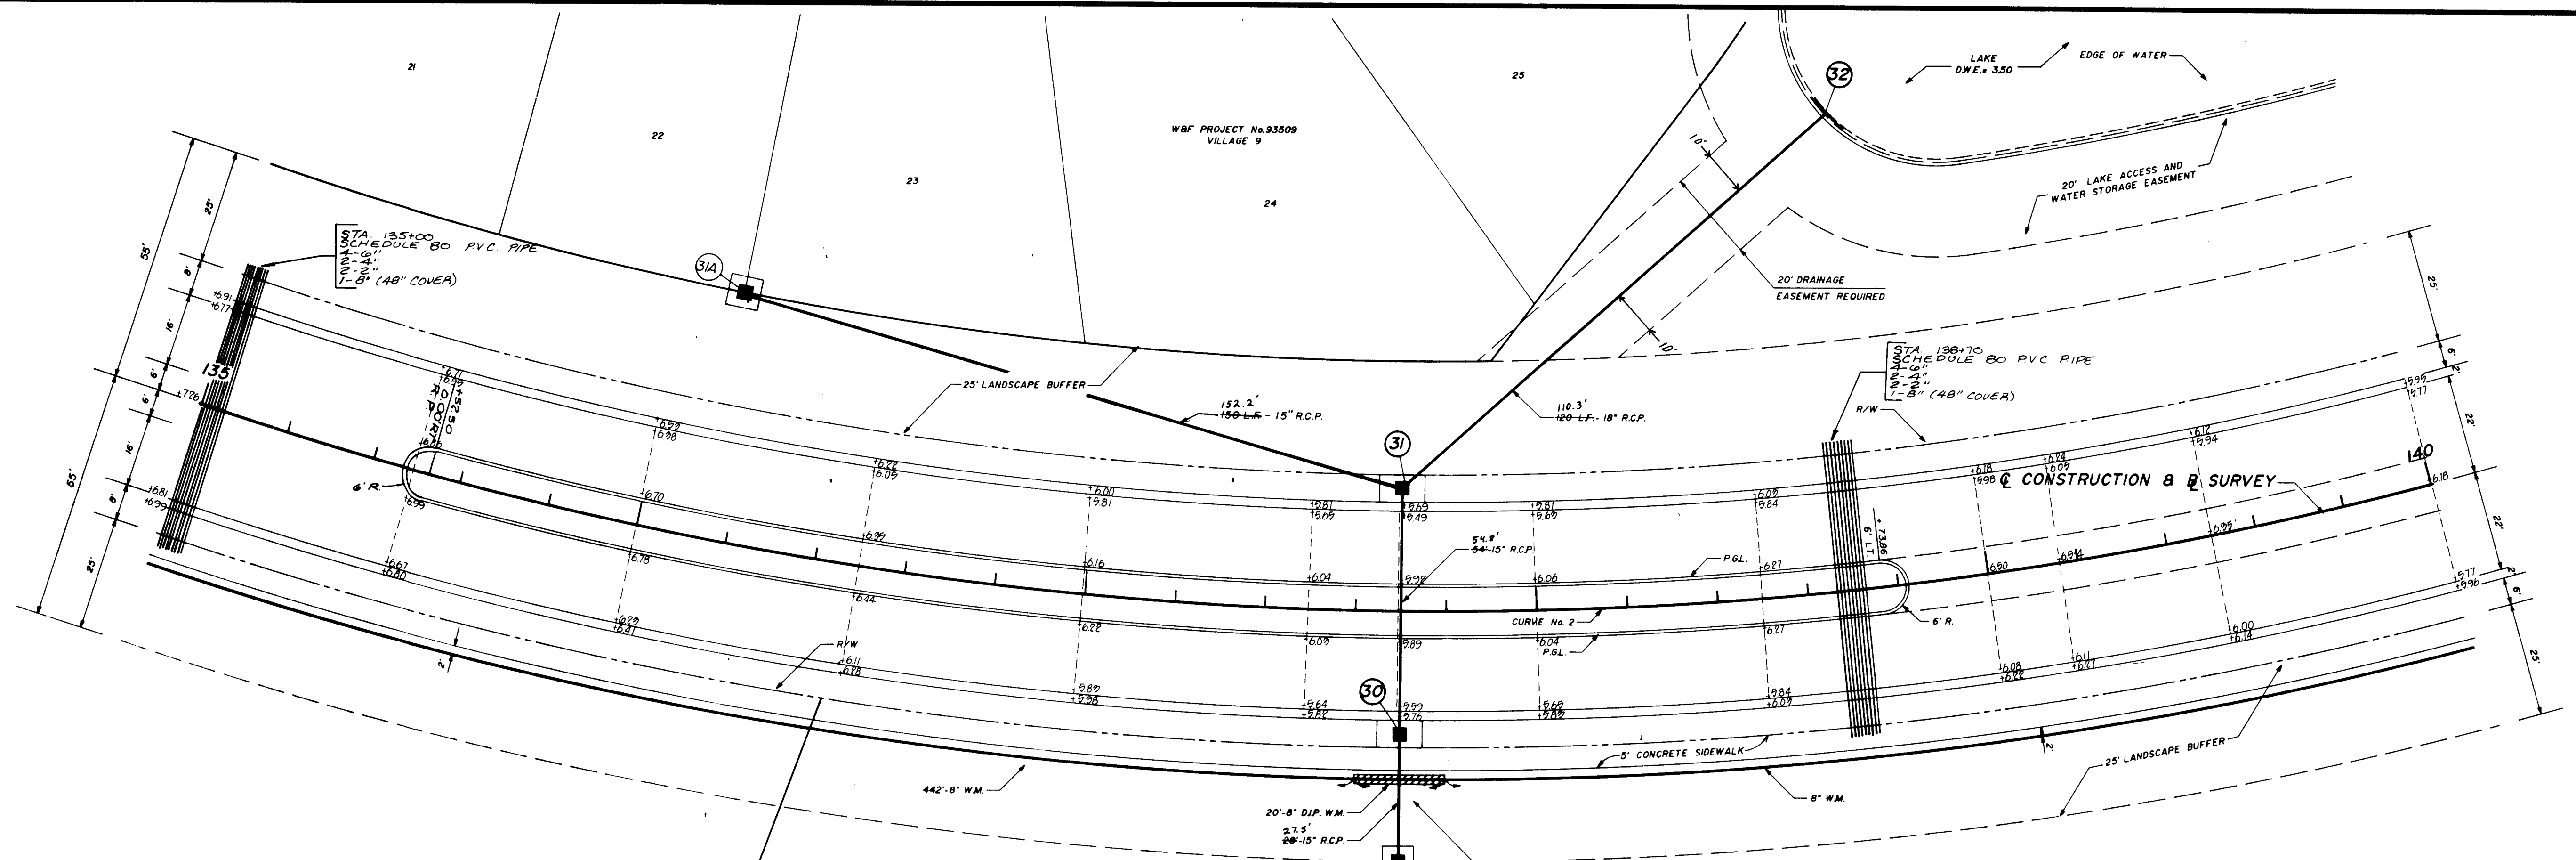


- 31A STA 135+00.00 LT. TYPE "C" INLET W/455-620 FRAME AND GRATE 2' CONCRETE APRON INDEX 132 RE 3-80 9.76 IE 300-1.99
- 29 STA 137+00.00 RT. TYPE "C" INLET W/455-620 FRAME & GRATE 2' CONCRETE APRON INDEX 232 RE 3-80 9.90 IE 300-2.97
- 30 STA 137+00.00 RT. TYPE "C" INLET W/CONC. APRON 455-620 FRAME AND GRATE INDEX 232 RE 3-80 9.90 IE 300-2.97
- 31 STA 137+00.00 RT. 4 DIA. TYPE "P-A" INLET W/PRB. CONCRETE APRON AND TOP SLAB INDEX 232 RE 3-80 9.90 IE 300-2.97
- 32 STA 138+630.97 LT. 11'-0" CONCRETE ENDWALL INDEX 250 IE 400-1.30 TOP 4.99
- STA 137+20.37 RT. WATER MAIN UNDER DRAINAGE USING 4'-8"x45" BENDS T.O.P. ELEV. 2.30

CURVE NO. 2 DATA
P.C. STA 135+53.00
R = 850.00
D = 6' 44.26"
Δ = 107°00'31"
L = 1587.5'
T = 1148.89'
P.I. STA = 137+03.99

SCALE: 1" = 20'

RECORD DRAWING (3 OF 4)

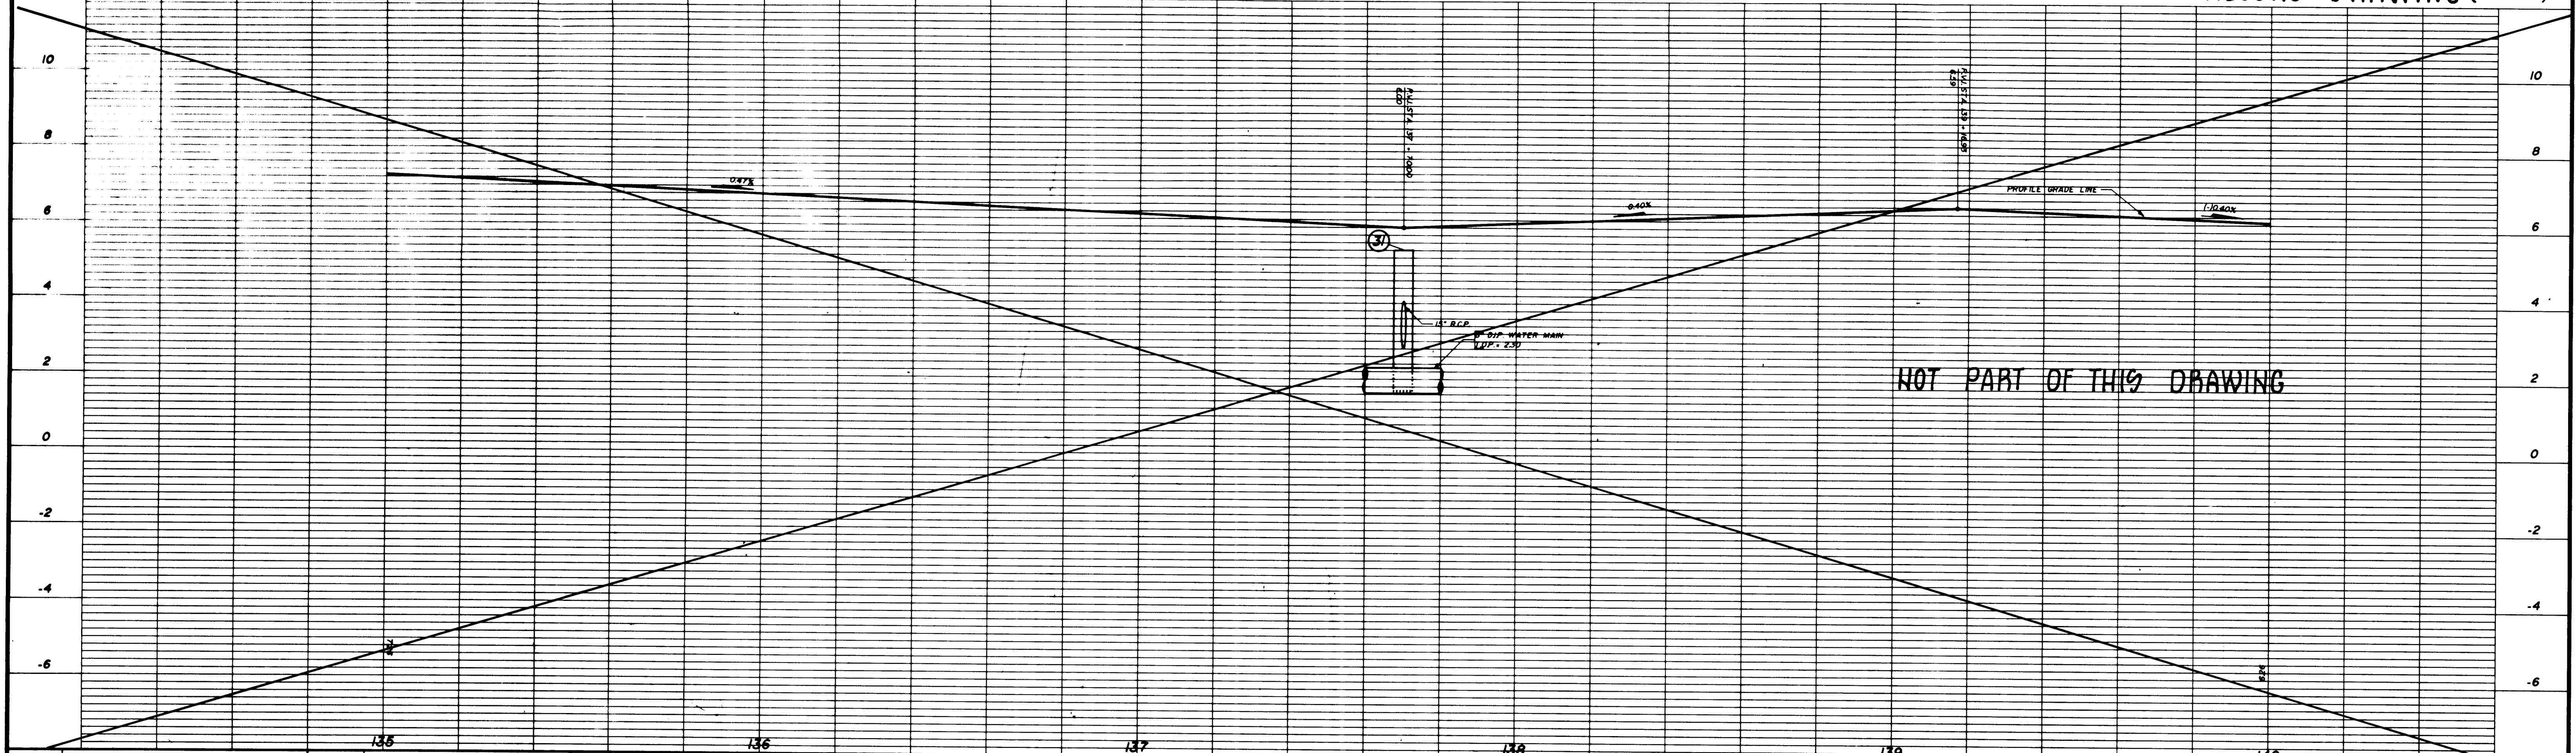

11/30/93	ADD INLET No. 31A @ 150' - 15" R.C.P.			DESIGNED: G.S.B. DATE: 6-93	TOWNGATE MINTO COMMUNITIES (PEMBROKE), INC. - GENERAL PARTNER	N.W. 155th. AVENUE STA. 135+00 TO 140+00	WINNINGHAM & FRADLEY, INC. ENGINEERS • PLANNERS • SURVEYORS	APPROVED: 
1/18/93	REVISE PER PEMBROKE PINES ENGINEERING	7/5/99	ADD TURN LANE STA. 132+50 ±	DRAWN: D.D.D. DATE: 6-93				DATE: 
1/18/93	REVISE PER PEMBROKE PINES UTILITIES	1/4/94	ADD CONDUIT CROSSING					PROJECT NUMBER: 93503
DATE	REVISIONS	DATE	REVISIONS	CHECKED:  DATE: 12/1/93				SHEET 19 OF 19


MAY 27 1997

MINTO	
YDR	DATE
ORDER NO.	9-11-94
FIELD BOOK	9404092
DATE	REVISION
ORDER NO.	

CERTIFICATE: I hereby certify that the above sketch, correctly represents a survey made under my direction and that said survey meets the minimum mechanical standards for land surveying in the State of Florida (Chapter 167, Florida Administrative Code).

By: *[Signature]*
P.E., No. 10911
State of Florida

Notary: This instrument is a true and correct copy of the original as it appears in the public records of the State of Florida.
Notary Public, State of Florida
DIETZ & DIETZ LAND SURVEYORS, INC.
1224 N. University Dr., Plantation, Florida 33322
(305) 475-7147

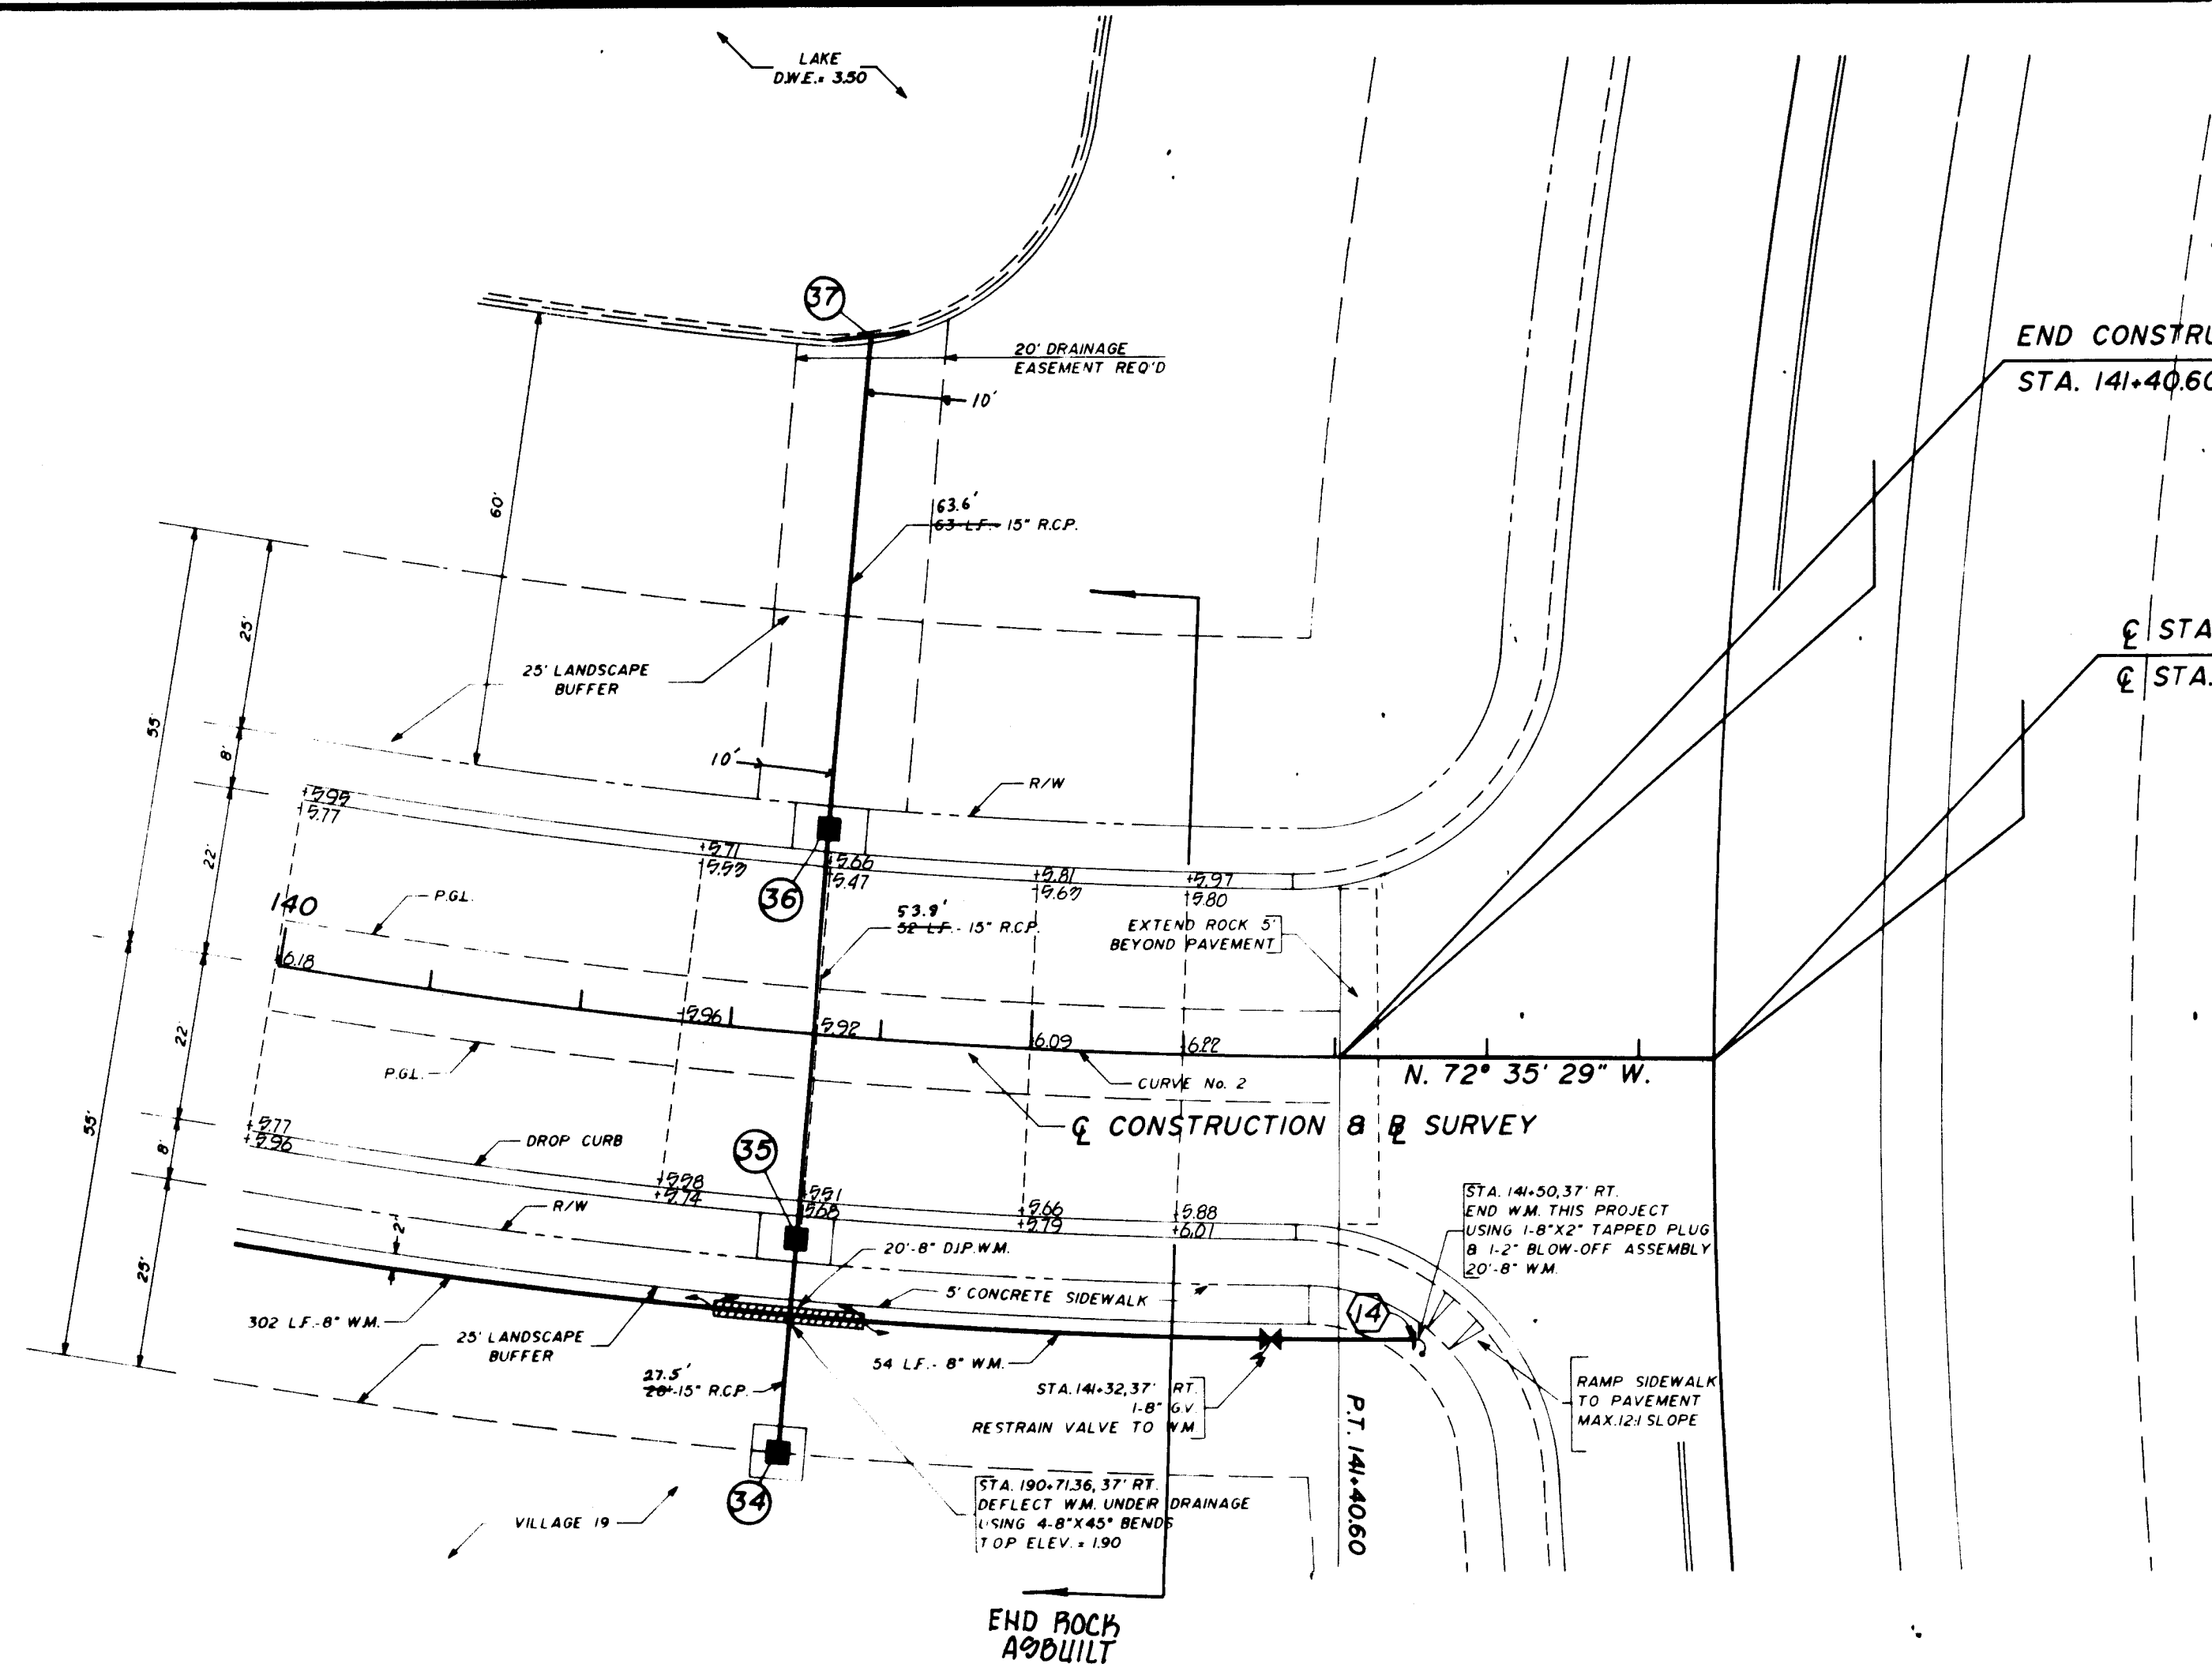

- 34 STA 140+71.36 22 RT.
TYPE "C" INLET
455-620 FRAME AND GRATE
INDEX NO. 234
RE 5-42 222
IE 2-40 226
- 35 STA 140+71.36 27 RT.
TYPE "C" INLET
455-620 FRAME AND GRATE
INDEX NO. 235
RE 5-42 222
IE 2-40 226
- 36 STA 140+71.36 27 LT.
TYPE "C" INLET W/ P/B
455-620 FRAME AND GRATE
INDEX NO. 236
RE 5-42 222
IE 2-40 226
- 37 STA 140+71.36 27 RT.
TYPE "C" INLET
455-620 FRAME AND GRATE
INDEX NO. 237
RE 5-42 222
IE 2-40 226
- CURVE NO. 2 DATA
P.C. STA 125+53.10
R = 850.00
D = 6°44'26"
Δ = 107°00'31"
L = 1587.51'
T = 1148.89'
P.I. STA. = 137+01.99

RECORD DRAWING (4 OF 4)

FOR: MINTO		
DATE:	8-11-94	
ORDER NO.:	9404092	
FIELD BOOK:	N/A	
DATE	REVISION	ORDER NO.
DIETZ & DIETZ LAND SURVEYORS, INC. 1224 N. University Dr., Plantation, Florida 33322 (305) 475-7147		

NOT PART OF THIS DRAWING

